



Dart Aerospace Ltd.
1270 Aberdeen St
Hawkesbury, ON
K6A 1K7
Canada

Tel (613) 632-5200
Fax 613 632-5246

13902-1-312
Job Sheet 183520



Part No: 13902-1-312

Job Qty: 1 ea

Part Name: AW139 Heavy Duty Maintenance Floor Boards & Cart



Part Weight: 0 lbs

Status: Scheduled

Priority: Medium

Job Created: 9/19/18

Job Tracking No:

Due Date: 11/29/18

Created By: Marie Lajeunesse

Type: SOLD

Description:

Note: DWG 13902-1-312 Rev. C IPP Rev. A 18.09.18 New issue DP Verify DD

Ship Via:

Bill of Materials

Job Routing

Op No	Operation	Qty	Start Date	Due Date	Standard		Workcenter/Supplier		Sign-off
					Setup hrs	Run Hrs	Workcenter / Supplier	Lead Time	
100	Purchasing	1 pcs		11/29/18	0.00	0.00	Purchasing		NOV 20 2018
110	Packaging	1 pcs		11/29/18	0.00	0.00	Packaging2		NOV 20 2018
120	QC	1 pcs		11/29/18	0.00	0.00	QC6		10-11-22
130	Packaging	1 pcs		11/29/18	0.00	0.00	Packaging3		MLC
140	QC21-FG	1 Ea		11/29/18	0.00	0.00	QC21		NOV 22 2018

Part Op 100 - Issue P/O: _____ MANUFACTURE 13902-1-312 AS PER DWG Cart and work boards. Handle must be
Descriptions: ~~telescopic or removable for shipping purposes~~. Supplier: METEC Certificate of conformity is required

Job BOM

Part / Item	Component Name	Quantity	Operation	Container
13902-1-312P	AW139 Heavy Duty Maintenance Floor Boards & Cart	1 (1 ea)	100-Purchasing	5129733
139-Workboards		1		5125445

Job Allocations

Operation	Component Part	Required	Inventory	Allocated
100-Purchasing	13902-1-312P	1	0	0

Part Specifications

Specifications could not be found.

Plex 9/19/18 10:48 AM Dart.lajeunesse.marie



Container No: S129734



Part: 13902-1-312

Job No: 183520

Serial No/Batch: S129734

Revision: C

Inspector:

Exp Date:

Instructions:

Dart Aerospace Ltd.
1270 Aberdeen Street
Hawkesbury, ON K6A 1K7
CANADA
TEL.: 1 613 632-5200
Email: sales@dartaero.com
www.dartaerospace.com

Date: 11/20/18

DQA: _____ Date: _____



WORK ORDER NON-CONFORMANCE / UPDATE

QA Closed: _____ Date: _____


Work Order update only ☐

Work Order: <u>183520/183521</u> Part No. <u>13902-1-312</u> NCR No. _____		DISPOSITION Rework ☐ Scrap ☐ Use-as-is ☒ Suspected Unapproved ☐		AGAINST DEPARTMENT/PROCESS <table style="width:100%;"> <tr> <td>Skid-tube ☐</td> <td>Cross tube ☐</td> <td>Water Jet ☐</td> <td>Engineering ☐</td> </tr> <tr> <td>Machining ☐</td> <td>Small Fab ☐</td> <td>Prod. Eng. Coord. ☐</td> <td>Quality ☐</td> </tr> <tr> <td>Thermoforming ☐</td> <td>Finishing ☐</td> <td>Rec/Store/Packaging ☐</td> <td>Other ☐</td> </tr> <tr> <td>Large Fab ☐</td> <td>Composite ☐</td> <td>Supplier ☒</td> <td></td> </tr> </table>				Skid-tube ☐	Cross tube ☐	Water Jet ☐	Engineering ☐	Machining ☐	Small Fab ☐	Prod. Eng. Coord. ☐	Quality ☐	Thermoforming ☐	Finishing ☐	Rec/Store/Packaging ☐	Other ☐	Large Fab ☐	Composite ☐	Supplier ☒	
Skid-tube ☐	Cross tube ☐	Water Jet ☐	Engineering ☐	
Machining ☐	Small Fab ☐	Prod. Eng. Coord. ☐	Quality ☐	
Thermoforming ☐	Finishing ☐	Rec/Store/Packaging ☐	Other ☐	
Large Fab ☐	Composite ☐	Supplier ☒	
Date : <u>NOV 21 2018</u>		Step #: <u>120</u>		QTY Effective : <u>①</u>		MRB (QSI042) Approval <u>Mr. [Signature]</u> <u>NOV 21/18</u>	
Description Work Order Deviation - AS PER ATTACHED DWG'S AND WORK ORDER, PARTS ARE TO HAVE TELESCOPIC OR REMOVABLE HANDLES. - MBTEC SUPPLIER				Disposition IT IS ACCEPTABLE TO HAVE THE HANDLES IN A FIXED, NON REMOVABLE POSITION. NO CHANGES TO SET FORM OR FUNCTION		Completed By Lead hand / Supervisor Approval Verification DAS 9 9-89 <u>18-11-22</u> QC / QA Coordinator Approval DAS 9 9-89 <u>18-11-22</u>	
Root Cause <table style="width:100%;"> <tr> <td>Environment ☐</td> <td>No Re-verification ☐</td> </tr> <tr> <td>Design ☐</td> <td>Operator ☐</td> </tr> <tr> <td>Doc/Data ☐</td> <td>Offset/Setup ☒</td> </tr> <tr> <td>Equip/Tooling ☐</td> <td>Supplier ☒</td> </tr> <tr> <td>Handling/Pre ☐</td> <td>Training ☐</td> </tr> <tr> <td>Material ☐</td> <td>Use for Testing ☐</td> </tr> <tr> <td>Internal Transport ☐</td> <td>Poor Information ☐</td> </tr> <tr> <td>Tribal Knowledge ☐</td> <td>Rushing ☐</td> </tr> <tr> <td>LOA ☐</td> <td>Product Improvement ☐</td> </tr> <tr> <td>Substation ☐</td> <td>Process Improvement ☐</td> </tr> <tr> <td>Past Expiry Date ☐</td> <td>Manufacturing Process ☐</td> </tr> <tr> <td>Misidentified ☐</td> <td>Past Due ☐</td> </tr> </table>				Environment ☐	No Re-verification ☐	Design ☐	Operator ☐	Doc/Data ☐	Offset/Setup ☒	Equip/Tooling ☐	Supplier ☒	Handling/Pre ☐	Training ☐	Material ☐	Use for Testing ☐	Internal Transport ☐	Poor Information ☐	Tribal Knowledge ☐	Rushing ☐	LOA ☐	Product Improvement ☐	Substation ☐	Process Improvement ☐	Past Expiry Date ☐	Manufacturing Process ☐	Misidentified ☐	Past Due ☐	FAULT CATEGORY <table style="width:100%;"> <tr> <td>Pressure/Forced ☐</td> <td>Temperature/Cure ☐</td> <td>Power Loss/Surge ☐</td> <td>Positioned Wrong ☐</td> </tr> <tr> <td>Bending ☐</td> <td>Set-up ☐</td> <td>Folio/Program ☐</td> <td>Outside Dimensions ☐</td> </tr> <tr> <td>Centre Not Concentric ☐</td> <td>BOM/Route ☐</td> <td>Grain ☐</td> <td>Over/Under tolerance ☐</td> </tr> <tr> <td>Cracks ☐</td> <td>Broken/Damage/Defect ☐</td> <td>Weld ☐</td> <td>Part Incorrect ☐</td> </tr> <tr> <td>Crimp/Kink/Ripple/Wave ☐</td> <td>Inspection Incomplete/Unqualified ☐</td> <td>Wrong Stock Pulled ☐</td> <td>Part Lost/Missing ☐</td> </tr> <tr> <td>Cuffs ☐</td> <td>Contamination ☐</td> <td>Out of Sequence ☐</td> <td>Part Moved ☐</td> </tr> <tr> <td>Crushing ☐</td> <td>Countersink ☐</td> <td>Off-set ☐</td> <td>Drawing ☐</td> </tr> <tr> <td>Heat Treat ☐</td> <td>Cut Too Short ☐</td> <td>Mislabeled ☐</td> <td>Finish ☐</td> </tr> <tr> <td>Wave/Twist in Tube ☐</td> <td>Instructions Incomplete/Unclear ☐</td> <td>☒ Fit/Function</td> <td>Misread ☐</td> </tr> <tr> <td>Marks/Chatter ☐</td> <td>Drill Holes ☐</td> <td>Misaligned/off center ☐</td> <td>Turning Sequence ☐</td> </tr> </table>				Pressure/Forced ☐	Temperature/Cure ☐	Power Loss/Surge ☐	Positioned Wrong ☐	Bending ☐	Set-up ☐	Folio/Program ☐	Outside Dimensions ☐	Centre Not Concentric ☐	BOM/Route ☐	Grain ☐	Over/Under tolerance ☐	Cracks ☐	Broken/Damage/Defect ☐	Weld ☐	Part Incorrect ☐	Crimp/Kink/Ripple/Wave ☐	Inspection Incomplete/Unqualified ☐	Wrong Stock Pulled ☐	Part Lost/Missing ☐	Cuffs ☐	Contamination ☐	Out of Sequence ☐	Part Moved ☐	Crushing ☐	Countersink ☐	Off-set ☐	Drawing ☐	Heat Treat ☐	Cut Too Short ☐	Mislabeled ☐	Finish ☐	Wave/Twist in Tube ☐	Instructions Incomplete/Unclear ☐	☒ Fit/Function	Misread ☐	Marks/Chatter ☐	Drill Holes ☐	Misaligned/off center ☐	Turning Sequence ☐
Environment ☐	No Re-verification ☐	
Design ☐	Operator ☐	
Doc/Data ☐	Offset/Setup ☒	
Equip/Tooling ☐	Supplier ☒	
Handling/Pre ☐	Training ☐	
Material ☐	Use for Testing ☐	
Internal Transport ☐	Poor Information ☐	
Tribal Knowledge ☐	Rushing ☐	
LOA ☐	Product Improvement ☐	
Substation ☐	Process Improvement ☐	
Past Expiry Date ☐	Manufacturing Process ☐	
Misidentified ☐	Past Due ☐	
Pressure/Forced ☐	Temperature/Cure ☐	Power Loss/Surge ☐	Positioned Wrong ☐	
Bending ☐	Set-up ☐	Folio/Program ☐	Outside Dimensions ☐	
Centre Not Concentric ☐	BOM/Route ☐	Grain ☐	Over/Under tolerance ☐	
Cracks ☐	Broken/Damage/Defect ☐	Weld ☐	Part Incorrect ☐	
Crimp/Kink/Ripple/Wave ☐	Inspection Incomplete/Unqualified ☐	Wrong Stock Pulled ☐	Part Lost/Missing ☐	
Cuffs ☐	Contamination ☐	Out of Sequence ☐	Part Moved ☐	
Crushing ☐	Countersink ☐	Off-set ☐	Drawing ☐	
Heat Treat ☐	Cut Too Short ☐	Mislabeled ☐	Finish ☐	
Wave/Twist in Tube ☐	Instructions Incomplete/Unclear ☐	☒ Fit/Function	Misread ☐	
Marks/Chatter ☐	Drill Holes ☐	Misaligned/off center ☐	Turning Sequence ☐	
OTHER : _____	


RELEASED FOR PROD.
 DATE: 04/24/14 INT. *wh*
 05-28-14 *wh*
 10-17-14 *wh*

SHOP COPY

REVISION					
REV	DRFTSMN	DATE	DESCRIPTION	APPROVED	DATE
--	DNN	8/2/12	INITIAL RELEASE.		
A	DNN	3/11/14	REPLACED SHEET 1 DEPICTION WITH PHOTO. ADDED LABEL INFO; UPDATED TITLE.		
B	DNN	4/22/14	ADDED SPECIFIC INSTRUCTIONS FOR THE "REMOVE BEFORE FLIGHT" STICKERS, THE IDENTIFICATION NUMBERS, AND THE "FWD" INDICATION MARKINGS; ADDED DETAIL FOR GRAB SLOT OPENING; ADDED NOTE TO BOND STRAPS TO FLOORBOARDS WITH ACRYLIC GLUE.		

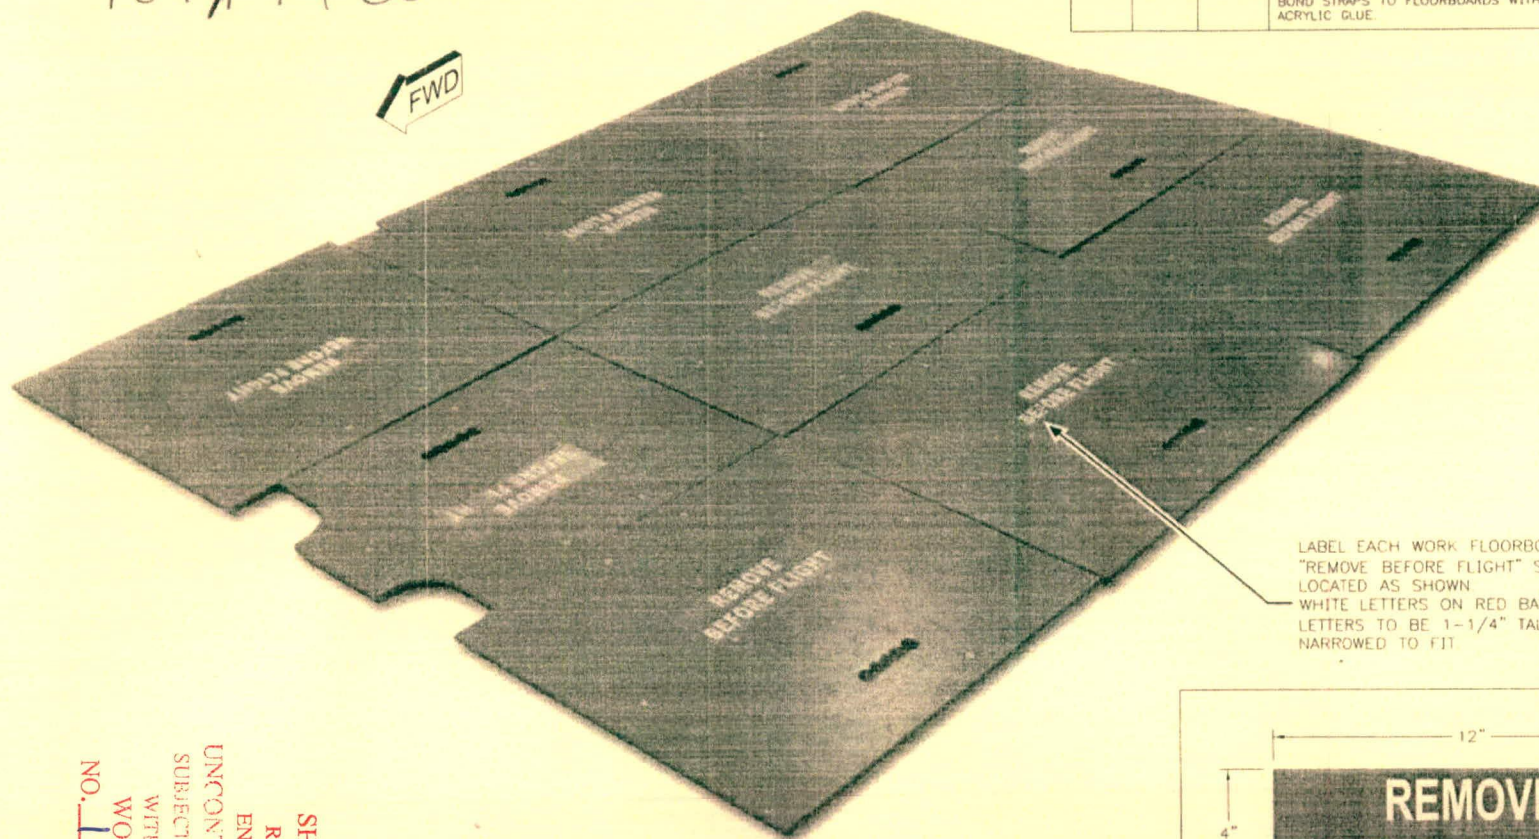

LABEL EACH WORK FLOORBOARD WITH "REMOVE BEFORE FLIGHT" STICKER, LOCATED AS SHOWN. WHITE LETTERS ON RED BACKGROUND. LETTERS TO BE 1-1/4" TALL, ARIAL BLACK, NARROWED TO FIT.

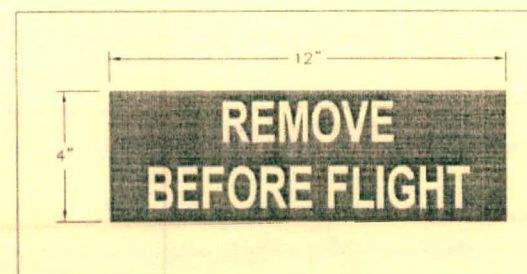


SHOP COPY
 RETURN TO
 ENGINEERING
 UNCONTROLLED COPY
 SUBJECT TO AMENDMENT
 WITHOUT NOTICE
 WORK ORDER
 NO. 183520 MJS
 1809-19

MATERIAL: 1/2" PVC BOARD
 HARDWARE: COUNTERSUNK SCREWS
 NUTS

PROPRIETARY RIGHTS NOTICE THESE DATA ARE PROPRIETARY TO ERA HELICOPTERS LLC. NO REPRODUCTION OR USE OF THESE DATA FOR ANY PURPOSE IS FORBIDDEN WITHOUT WRITTEN AUTHORIZATION FROM ERA HELICOPTERS LLC. THE FLOORBOARD LINES NOT APPLY TO: SERVICE PARTS.		DRAWN: DNN DATE: 8/2/12 CHKR: DATE:	Era ERA HELICOPTERS LLC 801 AIRPORT SERVICE ROAD LAKE CHARLES, LA 70605
UNLESS OTHERWISE SPECIFIED ALL ANGLES UNLESS NOTED XXX.00 X 1/2"		TITLE: AW139 CABIN WORK FLOORBOARDS, TOOL SIZE: C DWG NO: 139-WORKBOARDS SCALE: NONE	REV: B SHEET 1 OF 3

SHOP COPY

DATE: 04-24-14
05-28-14
10-17-14 INT: *[initials]*


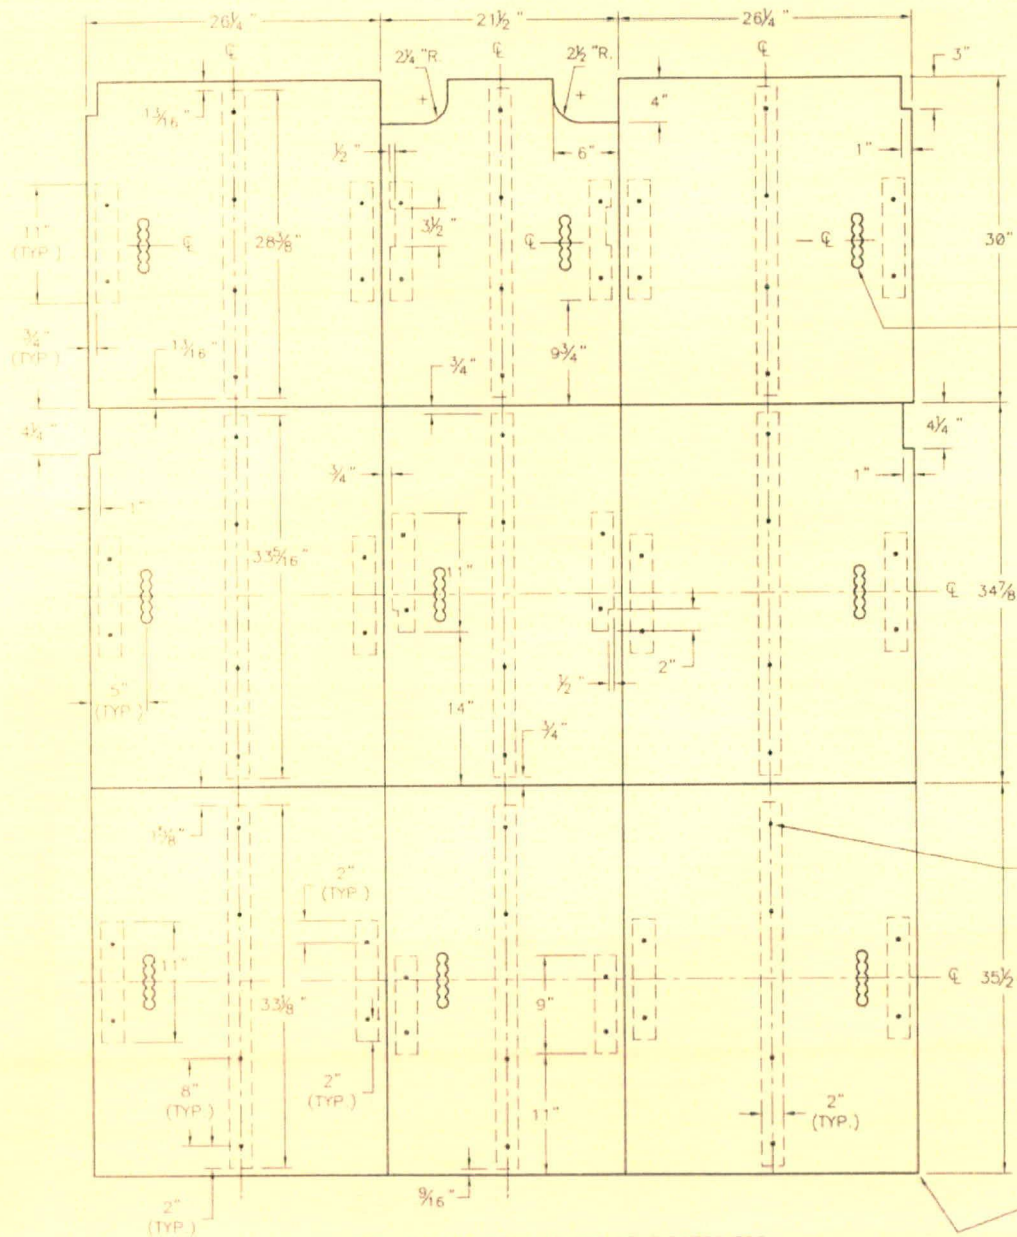


VIEW LOOKING DOWN AT TOP OF FLOORBOARDS



GRAB SLOT CENTERED
FWD & AFT,
LH SIDE FOR BOARDS
1, 4, 5, 7, 8;
RH SIDE FOR BOARDS
2, 3, 6, 9;
APPROX. LOCATIONS
SHOWN,
SEE DETAIL BELOW.


1	2	3
4	5	6
7	8	9

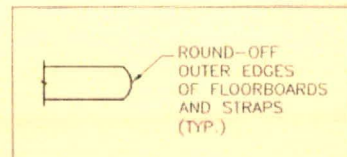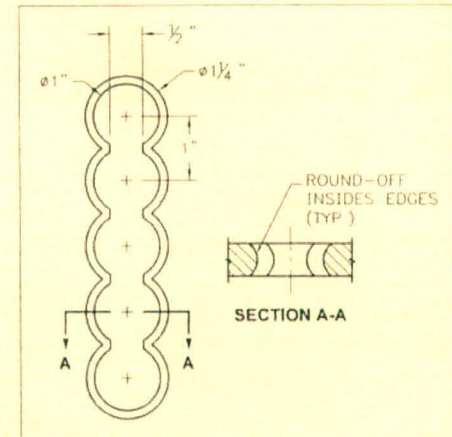


3/16" COUNTERSUNK
SCREWS, BOTTOM
C'BORED TO FLUSH
NUT AND SCREW
THREADS; BOND
STRAPS TO
FLOORBOARDS WITH
ACRYLIC GLUE.

ROUND-OFF
SHARP CORNERS
OF FLOORBOARDS
AND STRAPS.
(TYP.)

PROPRIETARY RIGHTS NOTICE THESE DATA ARE PROPRIETARY TO ERA HELICOPTERS, LLC. NO DISSEMINATION, REPRODUCTION, OR USE OF THESE DATA FOR ANY PURPOSE IS FORBIDDEN WITHOUT WRITTEN AUTHORIZATION FROM ERA HELICOPTERS, LLC. THE FOREGOING DOES NOT APPLY TO VENDOR PARTS.		ERA* ERA HELICOPTERS, LLC 400 AIRPORT SERVICE ROAD LAKE CHARLES, LA 70605	
TITLE AW139 CABIN WORK FLOORBOARDS, TOOL		REV B	
SIZE C	DWG NO. 139-WORKBOARDS	SCALE NONE	
SHEET 2 OF 3		REV B	

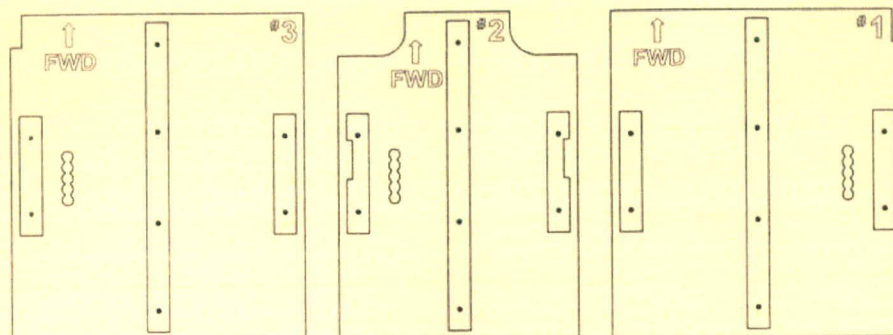


3	2	1
6	5	4
9	8	7

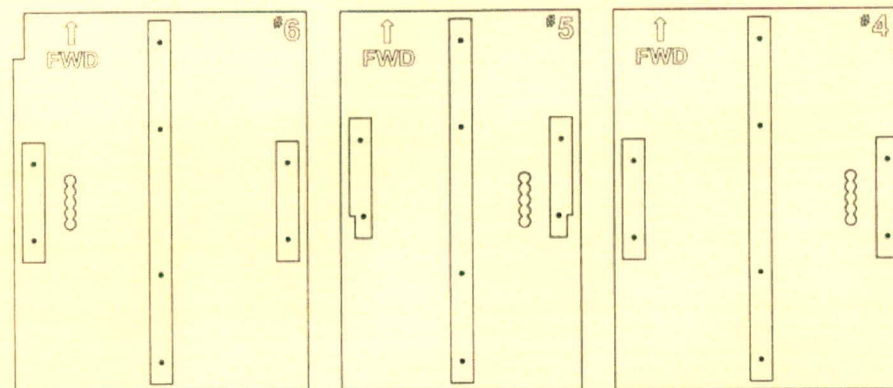

SHOP COPY
 RELEASED FOR PROD.
 DATE: 04/24/14 INT: ck
05-28-14 ck
10-17-14 ck

ENGRAVE INDIVIDUAL
 WORK FLOORBOARDS
 ON BOTTOM SIDES
 WITH "FWD" INDICATION.
 LETTERS TO BE
 1-1/4" TALL
 ARIAL BOLD.
 ARROW SYMBOL
 SIZED APPROX
 AS SHOWN.
 LOCATE APPROX
 AS SHOWN.

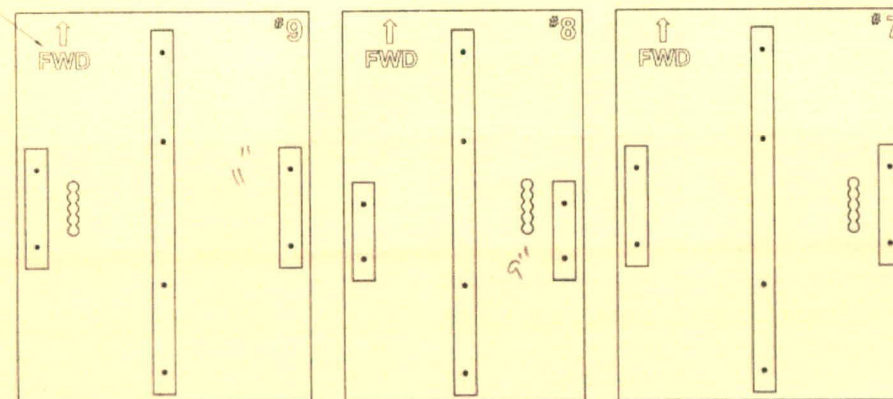

ENGRAVE INDIVIDUAL
 WORK FLOORBOARDS
 ON BOTTOM SIDES
 FOR IDENTIFICATION;
 NUMBERS TO BE 2" TALL
 ARIAL BOLD;
 "#" SYMBOL TO BE
 1-1/16" TALL
 ARIAL BOLD
 LOCATE APPROX.
 AS SHOWN.

VIEW LOOKING UP AT BOTTOM OF WORK FLOORBOARDS

PROPRIETARY RIGHTS NOTICE THESE DATA ARE UNCLASSIFIED TO ERA HELICOPTERS LLC. DISCLOSURE, REPRODUCTION, OR USE OF THESE DATA FOR ANY PURPOSES IS PROHIBITED WITHOUT WRITTEN AUTHORIZATION FROM ERA HELICOPTERS LLC. THIS FLOORBOARD DOES NOT APPLY TO: VENDOR PARTS.		Era ERA HELICOPTERS LLC 800 AIRPORT SERVICE ROAD LAKE CHARLES, LA 70605	
TITLE AW139 CABIN WORK FLOORBOARDS, TOOL		SIZE C	REV B
SCALE NONE		SHEET 3 OF 3	

FILE COPY

**FOR REFERENCE ONLY
NOT FOR PRODUCTION**



CART SHOWN WITH
AW139 FLOOR WORK BOARDS
IN THE SLOTS

REVISION

REV	DRAFTSMAN	DATE	DESCRIPTION	APPROVED	DATE
---	DNN	2/22/11	INITIAL RELEASE		
A	DNN	4/22/11	REDUCED NUMBER OF SLOTS TO 9; ADDED PULL BAR		
B	DNN	6/22/11	ADDED "9-SLOTS" TO DWG TITLE; CHG "9 SPACES" TO "9 SLOTS" ON SPACING DIMENSION OF TUBING; ADDED CALL-OUT TO CAP ALL OPEN TUBING; ADDED NOTE 1 FOR RED POWDER COAT FINISH; MOVED RIGID CASTERS AND SWIVEL CASTERS TO OPPOSITE ENDS; SPECIFIED THAT RIGID CASTERS HAVE LOCKS; SPECIFIED THAT ALL TUBING IS STEEL		
C	DNN	3/11/14	UPDATED DWG WITH PHOTOS OF CART		

05-28-14

Do not use these
dwgs per V.E.
use the shop
copies that are
Redlined
it

**OWNER
/OPERATOR
PRODUCED
PART**

CASTER PLATE

ITEM	QTY	PART NO.	NAME	STOCK SIZE	MATERIAL / NOTES
2			8" SWIVEL CASTER		
2			8" RIGID CASTER w/LOCK		
96"		7/8" DIA.	2x8" ROUND TUBING		STEEL
240"		1" SQ.	1" SQ. TUBING		STEEL
122"		2"	2" SQ. TUBING		STEEL
		13902-1-312-001	WORK FLOORBOARD CART, TOOL		


NOTE:

1. POWDER COAT COLOR RED.



PROPRIETARY RIGHTS NOTICE
THESE DATA ARE PROPRIETARY TO ERA HELICOPTERS LLC. DISCLOSURE, REPRODUCTION, OR USE OF THESE DATA FOR ANY PURPOSE IS FORBIDDEN WITHOUT WRITTEN AUTHORIZATION FROM ERA HELICOPTERS LLC. THE FOREGOING DOES NOT APPLY TO VENDOR PARTS.

DRAWN: DNN
DATE: 2/22/11
CHKD:
DATE:
UNLESS OTHERWISE SPECIFIED
X 1 1 ANGLES
XX 1 20
XXX 1 50

ERA ERA HELICOPTERS LLC
800 AIRPORT SERVICE ROAD
LAKE CHARLES, LA 70605
TITLE: WORK FLOORBOARD CART,
9-SLOTS, AW139
SIZE: C DWG NO: 13902-1-312 REV: C
SCALE: NONE SHEET 1 OF 2

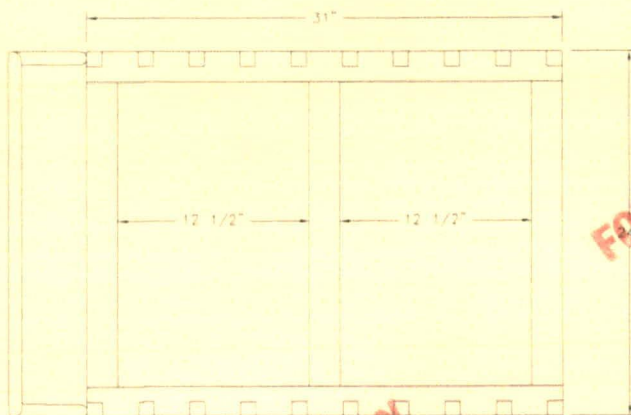

**FILE ONLY
FOR REFERENCE COPY
NOT FOR PRODUCTION**

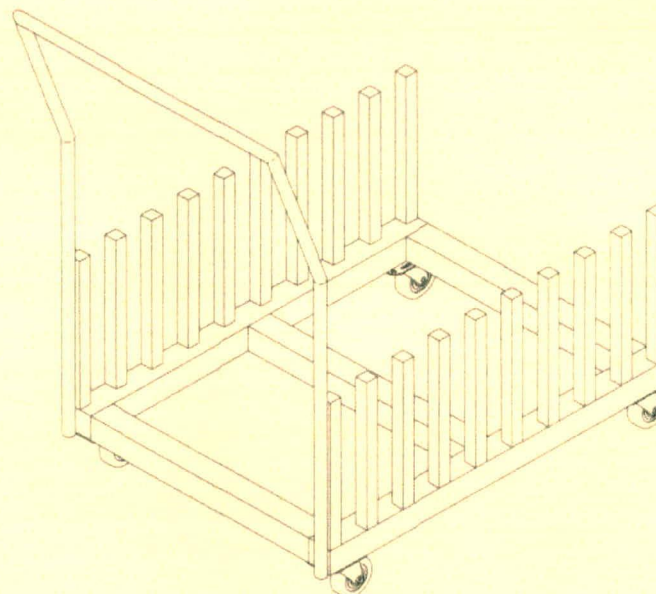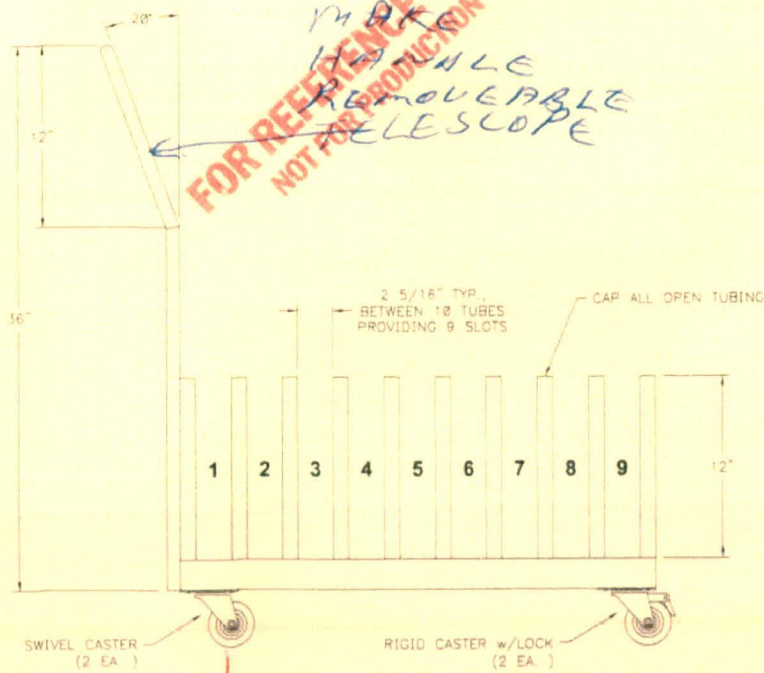

BRAKE

13902-1-312-001
WORK FLOORBOARD CART, TOOL

**OWNER / OPERATOR
PRODUCED PART**


PROPRIETARY RIGHTS NOTICE
THIS DATA AND
PROPRIETARY TO
ERA HELICOPTERS LLC.
DISSEMINATION, REPRO-
DUCTION, OR USE OF
THIS DATA FOR ANY
PURPOSE IS FORBIDDEN
WITHOUT WRITTEN
AUTHORIZATION FROM
ERA HELICOPTERS LLC.
THIS NOTICE DOES
NOT APPLY TO
VENDOR PARTS.

Era ERA HELICOPTERS LLC 400 AIRPORT SERVICE ROAD LAKE CHARLES, LA 70603	
TITLE WORK FLOORBOARD CART, 9-SLOTS, AW139	
SIZE C	DWG NO 13902-1-312
SCALE NONE	REV C
SHEET 2 OF 2	

FILE COPY

NO. 06 TOP PLATE TEMPLATE

**FOR REFERENCE ONLY
NOT FOR PRODUCTION**

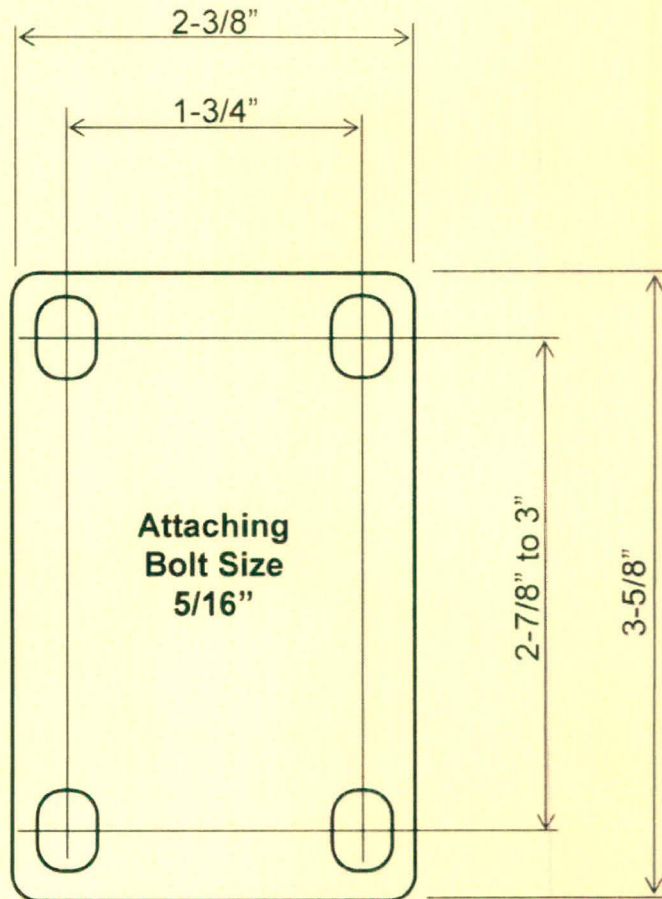

DRILL 32 HOLES on 4

**FOR REFERENCE ONLY
NOT FOR PRODUCTION**

****NOTE****

Sometime during faxing or printing the drawing size may change slightly; always go by the dimensions rather than the drawing.

Durable USA, Inc.
3005 Roy Orr Blvd.
Grand Prairie, TX 75050

Phone: 972-206-0951
Fax: 972-206-0950
www.durableusa.com

Part

NO. 06 TOP PLATE

DATE 8/2/2005



Dart Aerospace Ltd.
1270 Aberdeen St
Hawkesbury, ON
K6A 1K7
Canada

Tel (613) 632-5200
Fax 613 632-5246

ORDER ACKNOWLEDGEMENT

CUSTOMER	ORDER
Customer Code: CIRIS02 Sold To: MAIN TECH STORES NON AIRCRAFT 403 SQUADRON Casement Aerodrome, Baldonnell Dublin 22 Ireland Phone: 353 1 4037594 Ship To: MIN TECH STORES NON AIRCRAFT 403 SQUADRON Casement Aerodrome, Baldonnell, Dublin 22 Ireland	Order No : 8283 Date: 9/6/18 Ship-To Contact: Cpl.Shane Backer Email: ACCS@defenceforces.ie Cust PO No: CC/1808811/039358 FOB: Shipping Point Ship Via: TBA - to be advised Freight Terms: Third Party Billing Terms: Net 30 INCO Terms: Ex Works Order Taker: Kinga Lysiak Order Taker Phone: Order Taker Email: klysiak@dartaero.com

Line No	Due Date	Ship Date	Part	Description/Note	Quantity	Unit	Price	Unit	Extended Price
2	11/29/18	11/29/18	13902-1-312	AW139 Heavy Duty Maintenance Floor Boards & Cart 12 weeks ARO	1	pcs	\$6,485.00USD	pcs	\$6,485.00 USD
				Services - UPS Freight					\$325.00
Sub Total									\$6,810.00 USD
Grand Total									\$6,810.00 USD

ORDER NOTES

Freight TBA

Custom Clearance To Be Billed To Receiver

Duties & Taxes To Be Billed To Receiver

Ship Order As Soon As Possible

Ship Order Complete

Use Discounted Price On Shipping Documents

Waiting On Freight

All Prices Quoted In USD & Valid For 30 Days. All Parts Subject To Prior Sale & Are Ex-Works Manufacturing Facility In Hawkesbury, ON, Canada

As Form Of Payment We Accept Visa, Master Card, American Express, Wire Transfer & Check

Order Will Not Be Processed Until Payment Has Been Received In Full. Lead Time Begins After Receipt Of Payment

Remit to: DART Aerospace Ltd., 1270 Aberdeen Street, Hawkesbury, Ontario K6A 1K7 Canada

Tel: 613 632 5200

Fax: 613 632 5246

accounting@dartaero.com

GST/HST 10127 2607

Note: A minimum 15% restocking fee is applicable. Custom items are non-refundable. Full warranty details are available at www.dartaerospace.com

Latest Revision Provided Unless Otherwise Requested

Plex 9/19/18 10:56 AM dart.Lussier.Patrick



QUOTE MW-0059

Date: Aug 13, 2018

Page: 1

Ship To:

Dart Aerospace Ltd.
1270 Aberdeen Street
Hawkesbury, Ontario K6A 1K7

Dart Aerospace Ltd.
1270 Aberdeen Street
Hawkesbury, Ontario K6A 1K7

We are pleased to submit this quotation regarding your recent inquiry. Please review the following information.

Ship via pick up		FOB Vankleek Hill		Delivery 6 weeks ARO	
Quoted by Walz, Marc C.		Quotation valid for 15 days		Terms 2 % within 10 days / net 30	
Description		Quantity	Unit	Unit Price	Amount
Fabrication of Floorboard Cart, dwg 13902-1-312 Rev.C Buggy has fixed and non-telescopic handles powdercoated red McMaster casters # 2502T44 and 2502T64 or equivalent		1	Each	2,313.45	2,313.45
Subtotal:					2,313.45
H - HST 13%					
HST					300.75
METEC Metal Technology Inc. HST: #867 061 723					
Please note that subsequent labour and materials due to changes, alterations and/or drawing inconsistencies during production will be billed separately at a minimum charge of \$ 100.00. The delivered goods must be inspected upon receipt to confirm compliance. Should there be discrepancies please notify METEC within 30 days of delivery. The goods are otherwise deemed accepted.				Total Amount in CAD	2,614.20

METEC Metal Technology Inc. 20 Terry Fox Drive P.O. Box 781 Vankleek Hill ON K0B 1R0 Canada

Tel. 1-613-678-3957 & 1-613-678-2782 Fax 1-613-678-3956 www.metec.ca



Dart Aerospace Ltd.
1270 Aberdeen St
Hawkesbury, ON
K6A 1K7
Canada

Tel (613) 632-5200

PURCHASE ORDER **PO041075**

Supplier: MEM001-VC
Metec Metal Technology Inc.
20 Terry Fox Drive PO Box 781
Vankleek Hill
ON
K0B 1R0 Canada
Phone: 613 678 3957
Fax: 613 678 3956

Attention: Walz, Shigi

Ship To: 1270 Aberdeen Street
Hawkesbury
ON
K6A 1K7 Canada
Phone: 613-632-5200

PO No: PO041075

PO Date: 9/19/18

Due Date: 11/20/18

Purchase Order

Revision:

Revision Date:

Ship-To Contact: Phone:

Via: Ground

Pynt Terms: Net 30

Freight Terms:

Special Comments:

Items

Line Item	Job	Part	Supplier Part No	Item No	Description	Status	Account	Due Date	Order Quantity	Received Quantity	Balance	Unit Price (CAD)	Extended Price
1	183521	13902-1-312P			AW139 Heavy Duty Maintenance Floor Boards & Cart	Firmed	-	11/20/18	1 Ea	0 Ea	1 Ea	\$2,313.45/Ea	\$2,313.45
							X	NOV 20 2018					
2	183520	13902-1-312P			AW139 Heavy Duty Maintenance Floor Boards & Cart	Firmed	-	11/20/18	1 Ea	0 Ea	1 Ea	\$2,313.45/Ea	\$2,313.45
							X	NOV 20 2018					

Grand Total: \$4,626.90

Order Notes

Procurement Quality Clauses
A005 RIGHT OF ENTRY
A008 FIRST ARTICLE INSPECTION (FAI) BY SELLER, (DOCUMENTATION SENT TO DART AEROSPACE)
A012 CHEMICAL AND PHYSICAL TEST REPORTS
A016 PERSONNEL QUALIFICATION
A017 RAW MATERIAL IDENTIFICATION (AS APPLICABLE)
A026 CERTIFICATION OF MATERIAL CONFORMANCE
A041 QUALITY MANAGEMENT SYSTEM
A042 DART NOTIFICATION BY SUPPLIER
A043 RETENTION OF QUALITY DOCUMENT

A048 COUNTERFEIT PARTS AVOIDANCE, DETECTION, MITIGATION AND DISPOSITION PROGRAM
A049 SUPPLIER AWARENESS

Terms & Condition of Purchasing(Suppliers) and Procurement Quality Clauses are an integral part of our AS9100 requirements. To learn in detail, please visit www.dartaerospace.com for further explanation.

Plex 9/19/18 3:18 PM dart.Lussier.Patrick

**METAL TECHNOLOGY INC.****www.metec.ca | 20 Terry Fox Drive, Vankleek Hill, Ontario, Canada K0B 1R0 | Phone: +1 613-678-3957 Fax: +1 613-678-3956**

Packing List

Bill Dart Aerospace Ltd.
To: 1270 Aberdeen Street
Hawkesbury, ON K6A 1K7
Canada

Ship Dart Aerospace Ltd.
To: 1270 Aberdeen Street
Hawkesbury, ON K6A 1K7
Canada

Shipment No: 24260
Shipment Date: 20-Nov-2018
Ship Via: Pick up at METEC
Order Number: 3048
Order Date: 09/19/18

Customer Code: DART
Phone: (613) 632-9577
PO Number: PO041075 ✓
Terms: Net 60 Days

----- Quantity -----							
<u>Item</u>	<u>Open</u>	<u>Shipped</u>	<u>B/O</u>	<u>Canceled</u>	<u>Unit</u>	<u>Description</u>	<u>Revision</u> <u>Job Number</u>
1	2	2 ✓	0	0	EA	DART-13902-1-312P AW139 Heavy Duty Maintenance Floor Boards & Cart	3048-01

The delivered goods must be inspected upon receipt to confirm compliance. Should there be discrepancies please notify METEC within 30 days of delivery. The goods are otherwise deemed accepted.

Received In Good Order By _____



20 Terry Fox Drive, Vankleek Hill, Ontario K0B 1R0

Tel. (613) 678-3957 & (613) 678-2782 Fax (613) 678-3956 metec@metec.ca

CERTIFICATE OF CONFORMITY

SOLD TO:

Dart Aerospace Ltd.
1270 Aberdeen Street
Hawkesbury, Ont.
K6A 1K7

SHIPPED TO:


same

Quantity	Part Number	Part Name	Dwg Rev.#	P.O. Number
2 ✓	DART-13902-1-312P ✓	AW139 Heavy Duty Maintenance Floor Boards & Cart	C	41075 ✓

MATERIAL: supplied by METEC

We hereby certify that the above parts were made in conformance with applicable drawings.

METEC Metal Technology Inc.

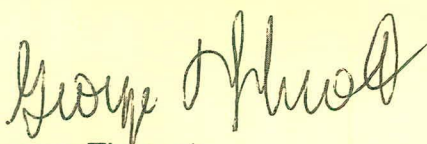
George Theoret

Vankleek Hill, November 20, 2018

